





MD 26 IS ASSUME TO RUN
IN EAST-WEST DIRECTION

PROPOSED SIGNS

25,27,29

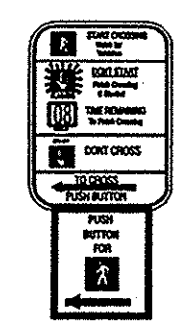


26

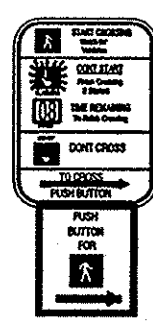



23,28




24,30

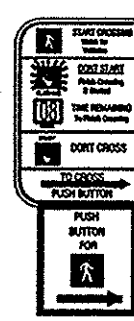





800-85, COUNTDOWN SIGN OPTION 'C'
(9'x12') WITH 800-87 PUSHBUTTON
SIGN OPTION 'A' (5'x7 3/4')

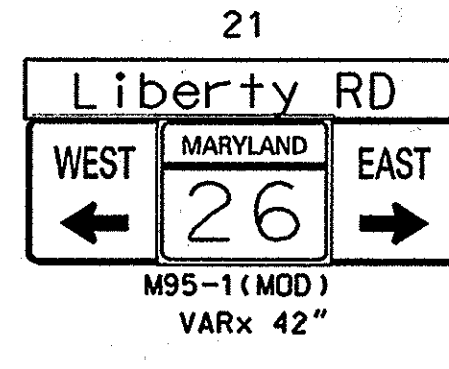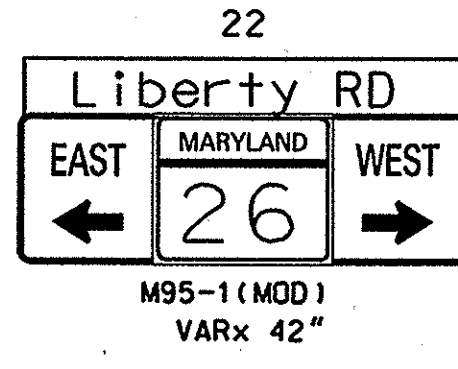

19,20

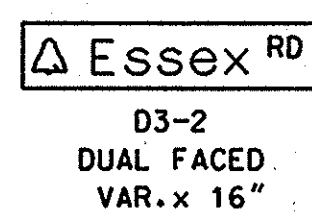

PROPOSED LED SIGNAL HEADS

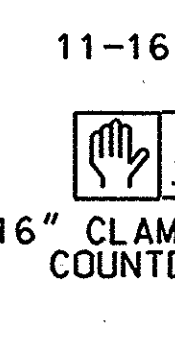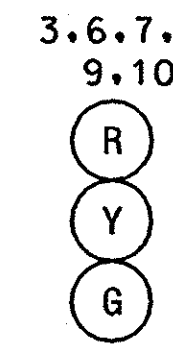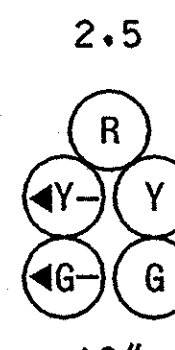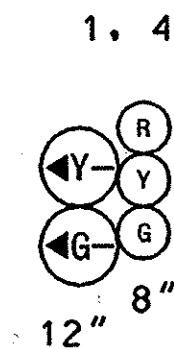


A,B,C,D

DETECTOR ZONES

VIDEO DETECTOR CAMERA

NEMA PHASING

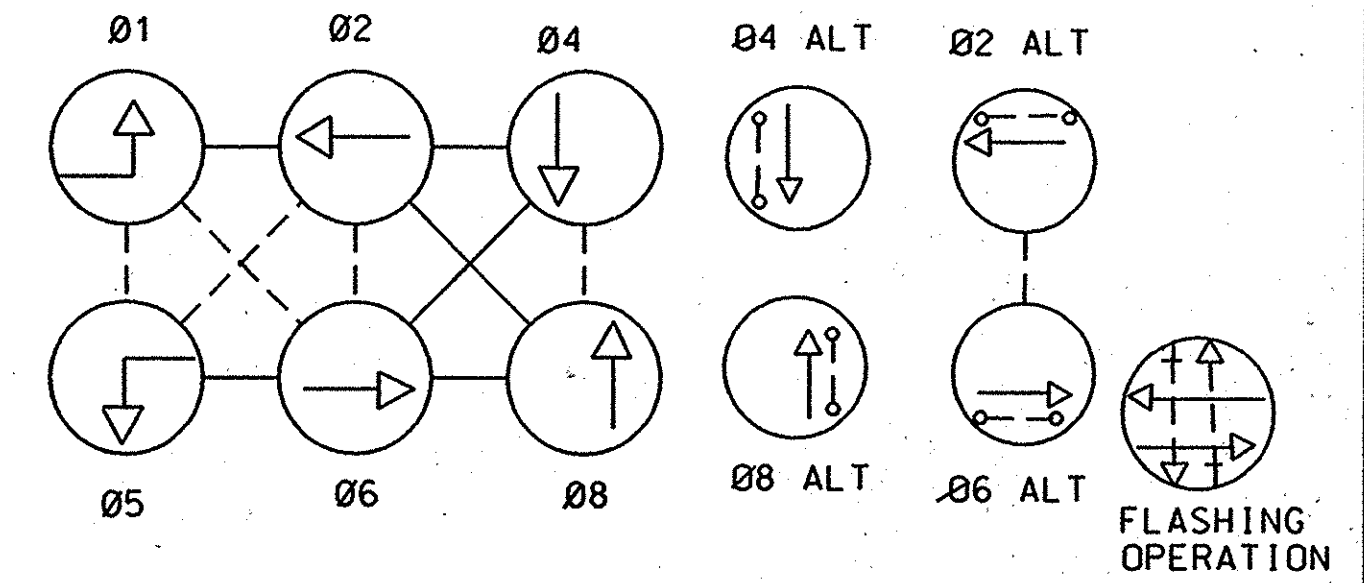


NEMA NOTES:

PHASES ASSOCIATED BY A DASHED LINE WILL OPERATE CONCURRENTLY.
PHASES ASSOCIATED BY A SOLID LINE WILL NOT OPERATE CONCURRENTLY.

CONSTRUCTION DETAILS

- INSTALL 27' (CUT TO 21') STEEL POLE WITH 50' (CUT TO 40') MAST ARM, TRAFFIC SIGNAL HEADS, SIGNS, VIDEO CAMERA (FOR FUTURE USE), COUNTDOWN PEDESTRIAN SIGNAL HEADS, SERVICE AND DISTRIBUTION EQUIPMENT AND NAVIGATOR AUDIBLE PEDESTRIAN PUSHBUTTON AND SIGN NO. 23. (NOTE: 1-3" AND 2-2" 90° PVC BEND).
- INSTALL 27' STEEL POLE WITH TWIN 50' MAST ARMS (CUT MAINLINE TO 40' AND SIDE RD. TO 46') TRAFFIC SIGNAL HEADS, SIGNS, COUNTDOWN PEDESTRIAN SIGNAL HEADS, NAVIGATOR AUDIBLE PEDESTRIAN PUSHBUTTON AND SIGN NO. 25, VIDEO CAMERAS, AND 15' LIGHTING ARM WITH 250 WATT HPS LUMINAIRE. (NOTE: 1-3" 90° PVC BEND).
- INSTALL 27' (CUT TO 21') STEEL POLE WITH 50' MAST ARM, TRAFFIC SIGNAL HEADS, SIGNS, VIDEO CAMERA, PEDESTRIAN SIGNAL HEADS AND NAVIGATOR AUDIBLE PEDESTRIAN PUSHBUTTON AND SIGN NO. 24. (NOTE: 1-3" 90° PVC BENDS).
- INSTALL SIZE '6' BASE-MOUNTED CABINET, WITH CONTROLLER AND ALL NECESSARY EQUIPMENT (THE SIDEWALK SHALL BE THE STANDING PAD. (NOTE: 2-4" & 2-2" 90° PVC BENDS).
- INSTALL 10' PEDESTAL POLE WITH BREAKAWAY BASE (CUT TO 6'). NAVIGATION AUDIBLE PEDESTRIAN PUSHBUTTON AND SIGN NO. 26. (NOTE: 1-3" 90° PVC BEND).

TO: BUCKINGHAM RD.

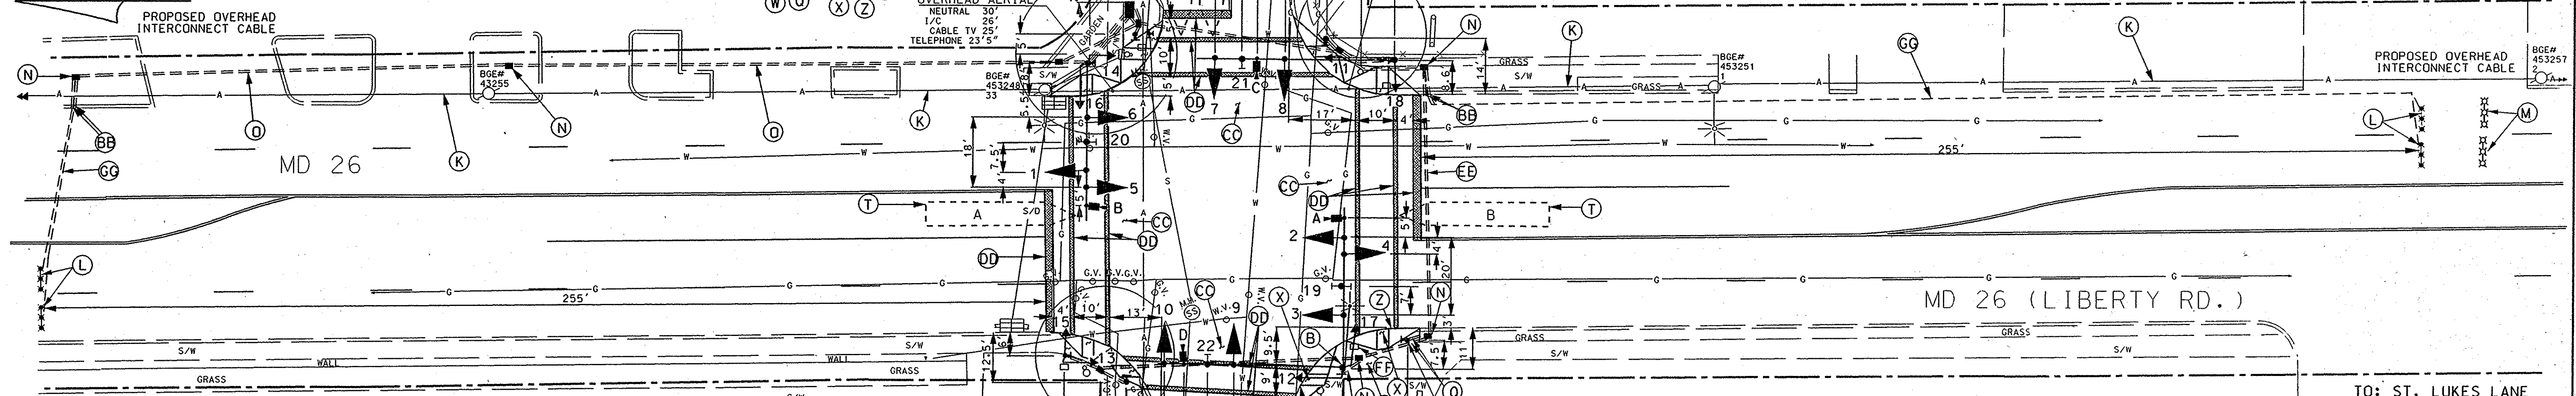

CONSTRUCTION DETAILS cont.

- INSTALL 10' PEDESTAL POLE WITH BREAKAWAY BASE. (CUT TO 6'). NAVIGATOR AUDIBLE PEDESTRIAN PUSH BUTTON WITH SIGN NO. 27. (NOTE: 1-3" 90° PVC BEND).
- INSTALL 10' PEDESTAL POLE WITH BREAKAWAY BASE. (CUT TO 6'). NAVIGATOR AUDIBLE PEDESTRIAN PUSH BUTTON WITH SIGN NO. 28. (NOTE: 1-3" 90° PVC BEND).
- INSTALL 10' PEDESTAL POLE WITH BREAKAWAY BASE. (CUT TO 6'). NAVIGATOR AUDIBLE PEDESTRIAN PUSH BUTTON WITH SIGN NO. 29. (NOTE: 1-3" 90° PVC BEND).
- INSTALL 10' PEDESTAL POLE WITH BREAKAWAY BASE, COUNTDOWN PEDESTRIAN SIGNAL HEADS, AND NAVIGATOR AUDIBLE PEDESTRIAN PUSH BUTTON WITH SIGN NO. 30. (NOTE: 1-3" 90° PVC BEND).
- REMOVE EXISTING AND INSTALL NEW OVERHEAD SELF SUPPORTING INTERCONNECT CABLE, IN KIND.
- INSTALL MICRO LOOP PROBE WITH 500' LEAD-IN CABLE.
- DISCONNECT AND ABANDON EXISTING PROBES.
- INSTALL ELECTRICAL HANDHOLE.
- INSTALL 4" SCHEDULE 80 PVC CONDUIT- BORED.
- INSTALL 4" SCHEDULE 80 PVC CONDUIT- TRENCHED.
- INSTALL 3" SCHEDULE 80 PVC CONDUIT- TRENCHED.
- INSTALL 2" SCHEDULE 80 PVC CONDUIT - TRENCHED FOR PHONE DROP.
- INSTALL 2" SCHEDULE 80 PVC CONDUIT- TRENCHED FOR SERVICE FEED.
- CAMERA DETECTOR ZONE
- OVERHEAD SERVICE INSTALLED BY BGE.
- USE BGE POLE NO. 273599 FOR OVERHEAD SERVICE FEED AND UNDERGROUND PHONE DROP TO SIGNAL POLE.
- INSTALL OVERHEAD 12 PAIR INTERCONNECT CABLE.
- EXCAVATE AND INSTALL PEDESTRIAN TYPE 'A' RAMP WITH 2' OF BRICK PAVERS AT THE ROAD EDGE.
- EXCAVATE EXISTING AND INSTALL PROPOSED 5" SIDEWALK.
- REMOVE EXISTING CURB AND GUTTER AND INSTALL STANDARD TYPE 'A' (DEPRESSED).
- REMOVE EXISTING POLE AND ALL ATTACHED EQUIPMENT. REMOVE FOUNDATION 12" BELOW GROUND GRADE.
- INSTALL 1" LIQUID TIGHT FLEXIBLE NON-METALLIC CONDUIT FOR DETECTOR SLEEVE.
- REMOVE EXISTING PAVEMENT MARKINGS, NOT SHOWN.
- INSTALL PROPOSED PAVEMENT MARKINGS, AS INDICATED.
- INSTALL 4" SCHEDULE 80 PVC CONDUIT - SLOTTED.
- REMOVE EXISTING HANDHOLE, CAP AND ABANDON EXISTING CONDUIT.
- SAWCUT FOR PROBE LEAD-IN CABLE INSTALLATION.
- DISCONNECT EXISTING SERVICE FEED.

GENERAL NOTES:

- ALL UNDERGROUND UTILITIES SHOWN ON PLANS ARE SCHEMATIC ONLY AND MAY NOT BE COMPLETE. THE CONTRACTOR SHALL BE RESPONSIBLE FOR NOTIFYING "MISS UTILITY" PRIOR TO CONSTRUCTION SO THAT ALL UTILITIES MAY BE LOCATED IN THE FIELD. IF THE CONTRACTOR PERCEIVES THAT A CONFLICT BETWEEN THE UTILITIES AND THE PROPOSED TRAFFIC SIGNAL EQUIPMENT WILL OCCUR, THE CONTRACTOR SHALL NOTIFY THE PROJECT ENGINEER IMMEDIATELY SO THAT THE CONFLICT MAY BE RESOLVED.
- ALL TRAFFIC SIGNAL FOUNDATIONS SHALL BE INSTALLED AT THE FINAL SIDEWALK OR CURB GRADE FOR CLOSED SECTIONS. HIGHEST ROADWAY GRADE FOR OPEN SECTION, TO MEET CLEARANCES AS SPECIFIED IN MD 816.03, MD 818.01, MD 818.02, AND MD 818.04. THE CONTRACTOR SHALL VERIFY ULTIMATE GRADES PRIOR TO THE INSTALLATION OF ALL PROPOSED SIGNAL EQUIPMENT.
- THE CONTRACTOR SHALL PURCHASE AND DELIVER NAVIGATOR CENTRAL CONTROL UNIT FOR THE CONTROLLER TO SHA SIGNAL SHOP AT 7491 CONNELLEY DRIVE, HANOVER, MD 21076. MR. EDWARD RODENHIZER AT (410) 787-7652 SHALL BE CONTACTED AT LEAST THREE (3) DAYS PRIOR TO THE DELIVERY.
- PROPOSED SIGNAL EQUIPMENT SHALL BE INSTALLED PRIOR TO 5" SIDEWALK.
- A PHONE DROP SHALL BE ARRANGED WITH MR. ROBERT SNYDER, OOTS AT 410-7877631. THE CONTRACTOR SHALL PROVIDE (72) SEVENTY-TWO HOURS NOTICE PRIOR TO THE COMPLETION OF THE PROJECT AND SHALL PROVIDE THE NEAREST ADDRESS.
- THE CONDUIT AND CURB MODIFICATION SHALL BE COMPLETED PRIOR TO THE INSTALLATION OF THE PAVEMENT MARKINGS.

TS 5 OF 10

REVISIONS				APPROVALS	
1	RECONSTRUCT TO MAST ARM & 6/27/05			TEAM LEADER, TRAFFIC ENGINEERING DESIGN DIVISION	DATE: 7/03
2	ADD VIDEO CAMERA, AUDIO PED'S				
3	SHA NO. BA 4845176			ASST. CHIEF TRAFFIC ENGINEERING DESIGN DIVISION	DATE: 3/90
4	AS-BUILT-ADD ADVANCE PED'S				
5	CROSS MD 26			CHIEF TRAFFIC ENGINEERING DESIGN DIVISION	DATE: 8/77
6	ADD E/P LEFT TURN				
7	EB AND WB MD 26			DIRECTOR, TRAFFIC & SAFETY	DATE: 4/1/1965
8	ADD 12" SIGNAL HEADS				
9	AND LOOP DETECTORS				

CENTURY ENGINEERING, INC.
CONSULTING ENGINEERS - PLANNERS
22 WEST ROAD
TOWSON, MARYLAND 21204
410-823-8070

MARYLAND DOT - STATE HIGHWAY ADMINISTRATION Office of Traffic & Safety TRAFFIC ENGINEERING DESIGN DIVISION TRAFFIC SIGNAL PLAN MD 26 (LIBERTY RD.) AND ESSEX ROAD			
DRAWN BY: E.L. FEIST	F.A.P. NO. ?	TS NO. 121 F	SHEET NO. 19 OF 28
CHECKED BY: 1" = 20'	COUNTY: BALTIMORE	T.L.M.S. NO. 6503	
DATE: 4/1/1965	LOG MILE: 0302608.89		

0: *TRANS DWG#23024.12# FINAL DESIGN#G503 PSM26 ESSEX.dgn 7/14/2005